2 EXISTING NORTH WEST - AS BUILT
1 : 100

1 PROPOSED NORTH WEST
1 : 100

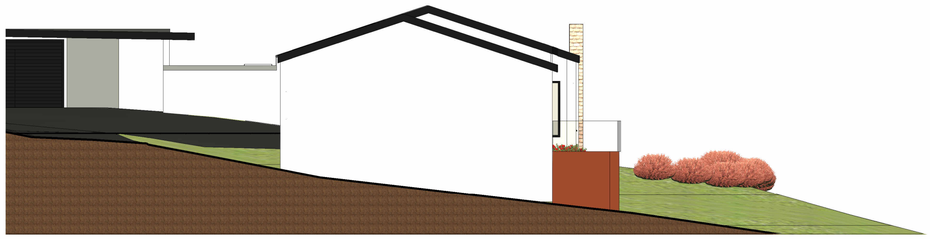

3 PROPOED NORTH EAST
1 : 100

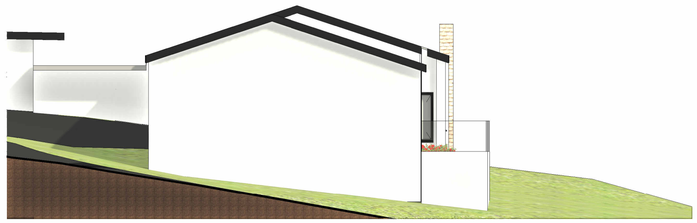

4 EXISTING NORTH EAST - AS BUILT
1 : 100

Peter Hitchen
Architects

Marathon House
The Sidings Business Park
Whalley, BB7 9SE

01254 823 885

www.peterhitchenarchitects.co.uk

NOTES:

No.	Description	Date

CLIENT:

MR & MRS HOWARTH

PROJECT:

ALTERATIONS & SIDE EXTENSION TO 42 PAINTER WOOD

SHEET:

EXISTING AND PROPOSED ELEVATIONS FRONT

Project number	PHA/410
Date	12/12/2019
Drawn by	RH
Checked by	PH

A300

Scale	1 : 100
Sheet size	A1