This drawing is to be read in conjunction with all relevant Architect, consultants' and specialists' drawings and specifications. The Architect is to be notified of any discrepancies before proceeding. Do not scale from this drawing. All dimensions and levels are to be checked on site. This drawing is subject to copyright. All work carried out before Planning and Building Permission has been granted is at the contractor/clients risk.

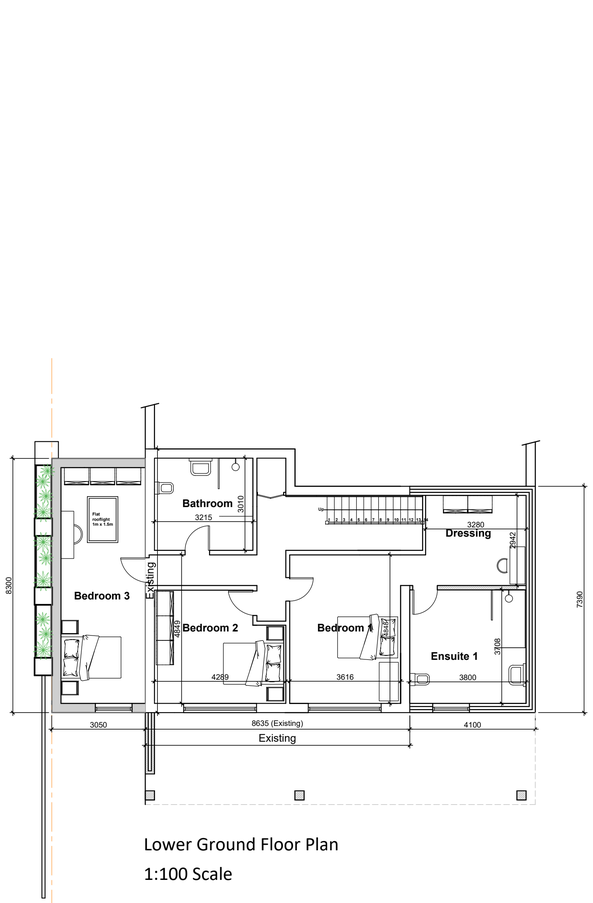

Lower Ground Floor Plan

1:100 Scale

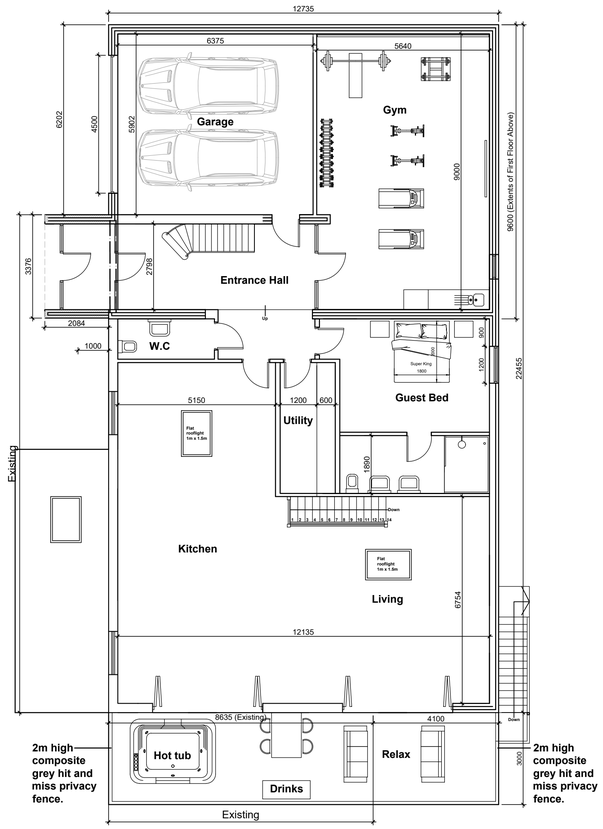

Ground Floor Plan

1:100 Scale

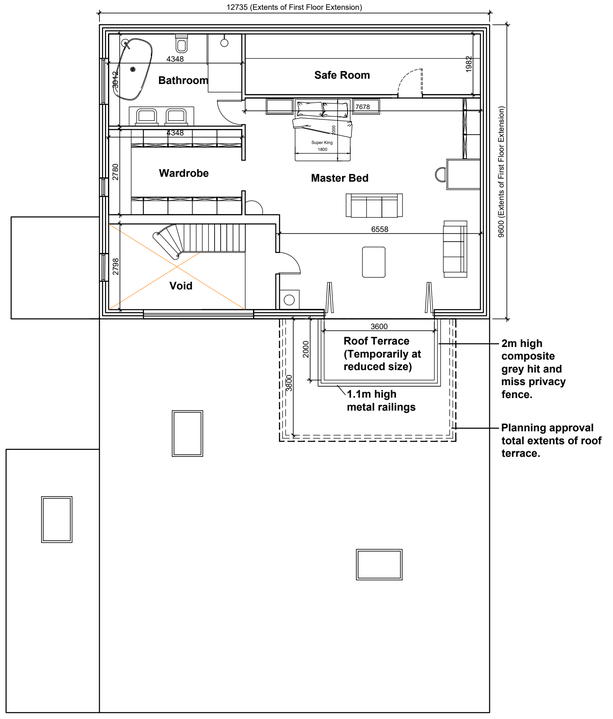

First Floor Plan

1:100 Scale

Rev I: Updated to As Built (in progress). 08.12.2025. Craig Harrison
Rev G: Window included to Guest Bedroom. 14.02.2023. Craig Harrison
Rev F: Client amendments, to layout to suit new kitchen, rooflights added etc, width of whole house increased by 300mm as instructed by Client. 22.11.2021. Craig Harrison

Client
Mr John Houston

Job Title
Proposed Alterations to
8 Hammond Drive
Read

Drawing Title
Proposed Floor Plans

Scale	Date	Drawn
1:100 @ A1	April 2021	Craig Harrison

SUNDERLAND PEACOCK ARCHITECTS
SUNDERLAND PEACOCK & ASSOCIATES LTD.
HAZELMERE, PIMLICO ROAD, CLITHEROE
LANCASHIRE, BB7 2AG
T 01200 423178 F 01200 427328
E info@sunderlandpeacock.com
www.sunderlandpeacock.com

6219 - P02I