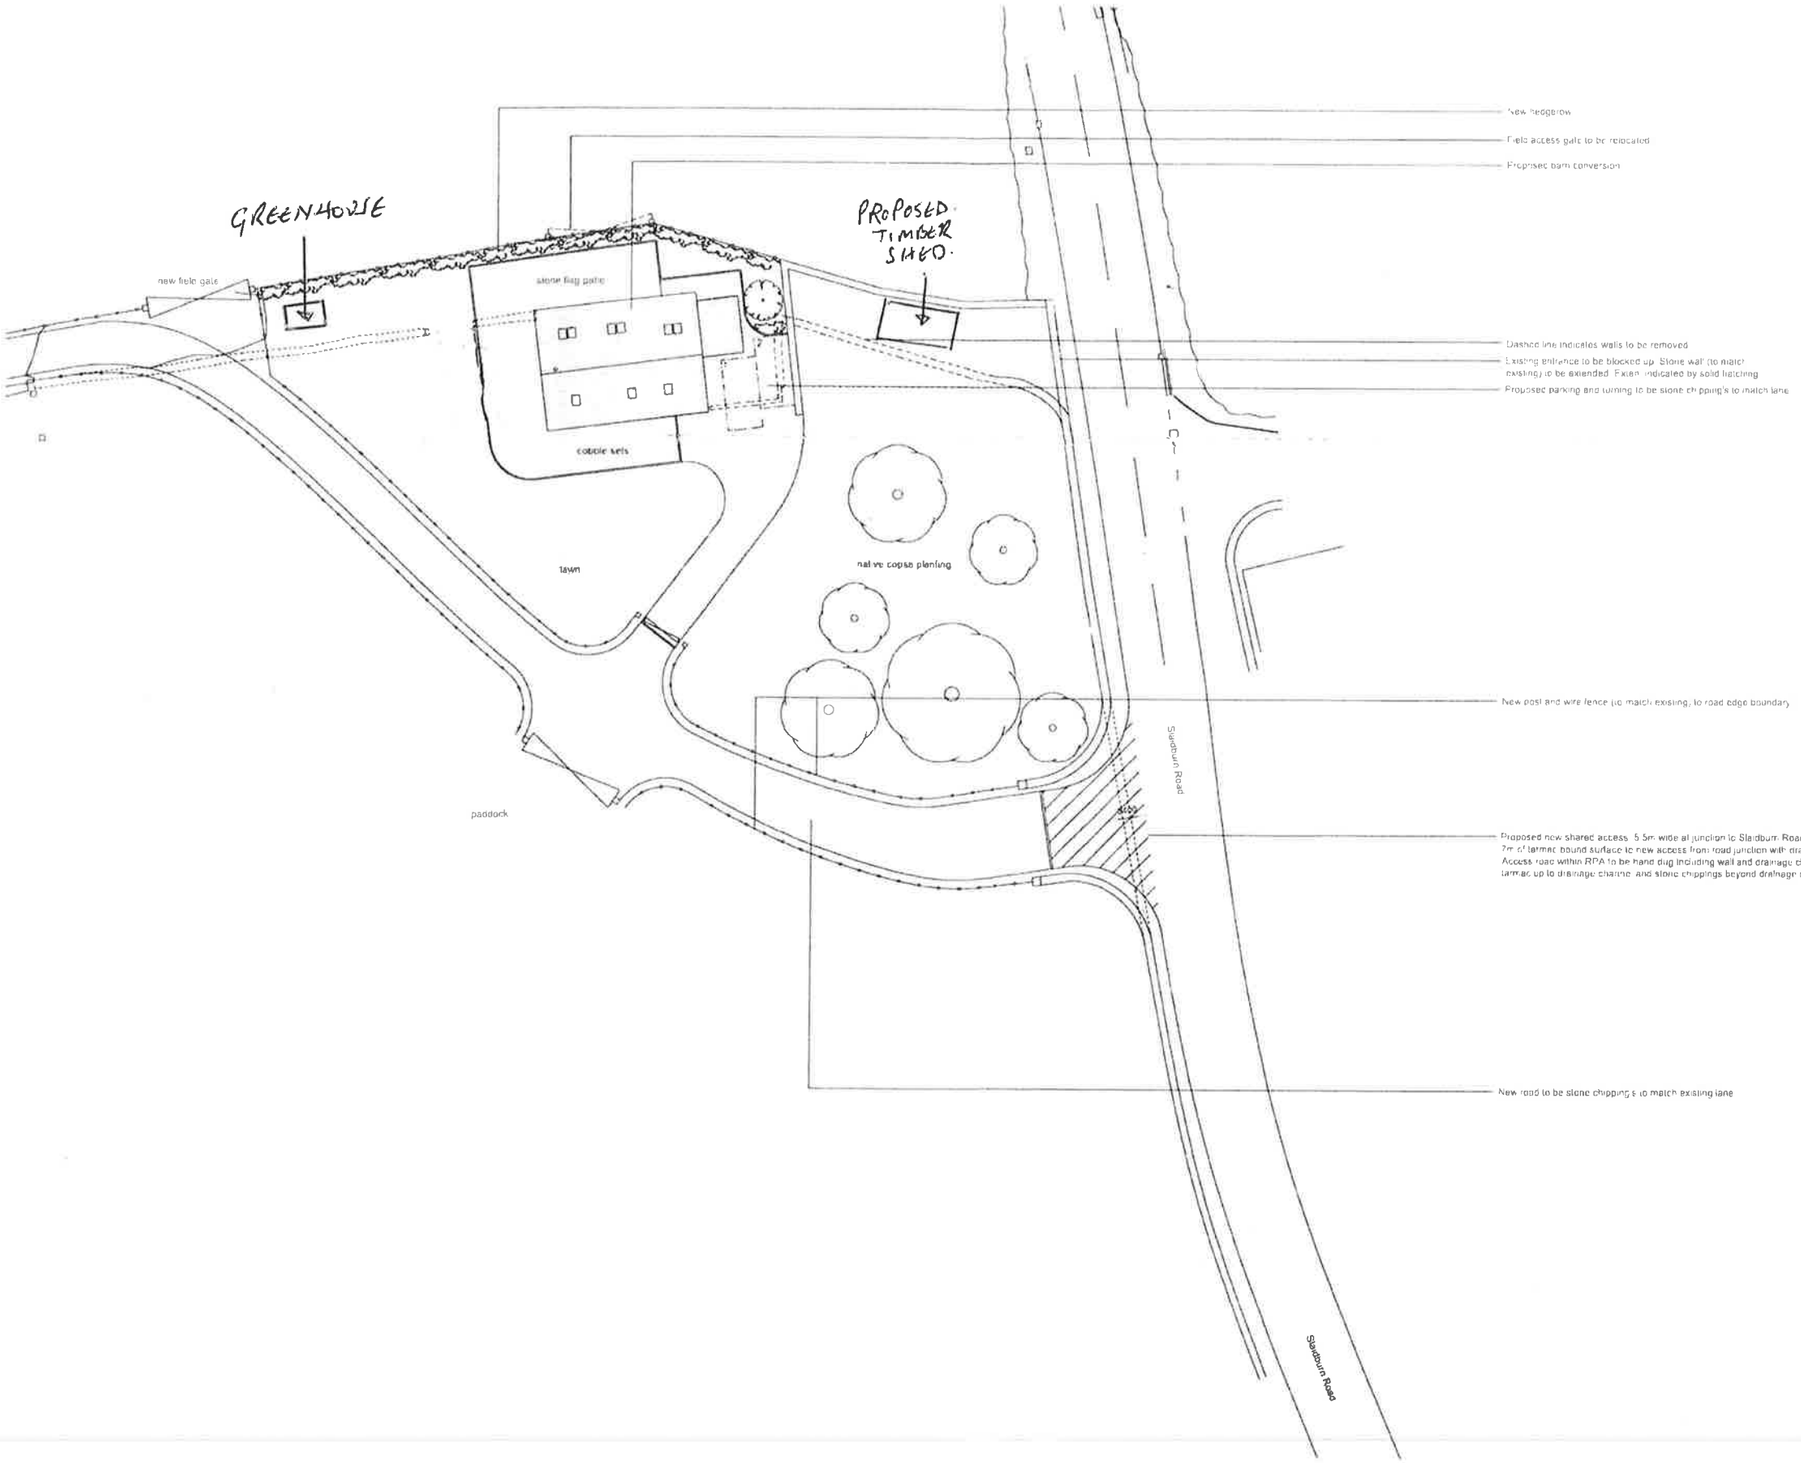

Notes

This drawing is the property of Peak Architecture Ltd and copyright is reserved by them. This drawing is not to be reproduced or disclosed to any unauthorised persons without the written consent of Peak Architecture Ltd.

Do not scale from this drawing.

All dimensions are to be checked on site prior to construction, manufacture of any components and ordering of materials and equipment.

Any discrepancies are to be reported to the architect immediately.

All materials and workmanship to be in accordance with the current British Standards and codes of practice.

Rev Date Drawn by Comments

Client

Project
Betty Barn, Slaidburn Road
Waddington

Drawing
As built Site Plan

Date	Drawn by	Scales
05.12.2024	SFM	1:200 @ A1

Jnt No Dwg No Rev
22065 - SP - C

PEAK ARCHITECTURE